



HEROUX DEVTEK DR.

REFERENCE DWG. #PP16

REFERENCE DWG. #PP05

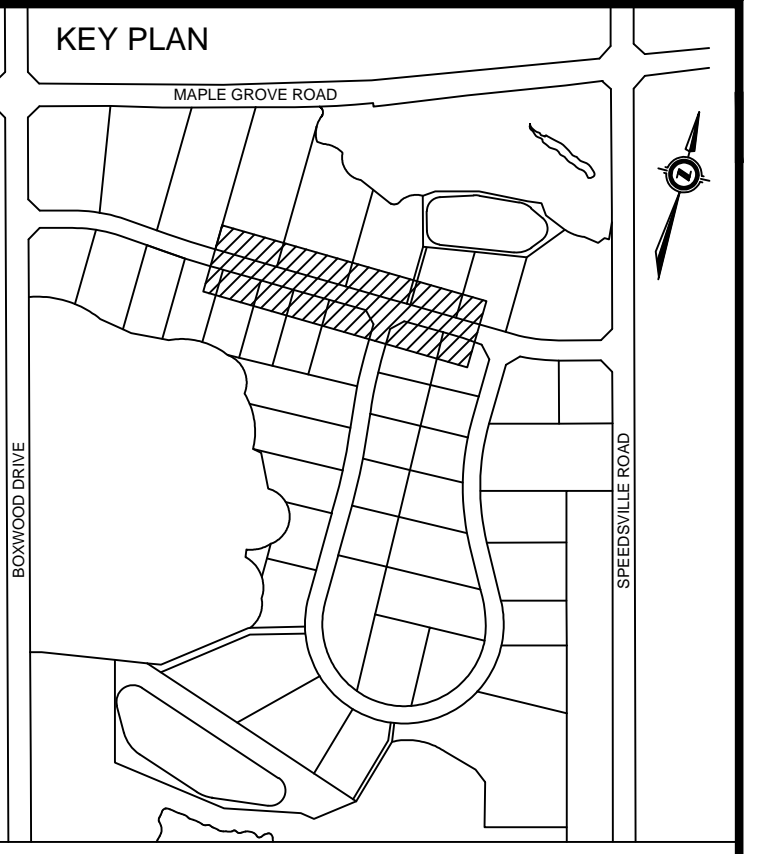

BENCHMARKS
 BMK317: ELVE. 306.269
 TABLET IN FOUNDATION OF WHITE BRICK PORTION OF FORMER MAPLE GROVE SCHOOL ON MAPLE GROVE ROAD AT SPEEDVILLE ROAD. TABLET IS IN SOUTH SIDE OF BUILDING 0.10M WEST OF SOUTH EAST CORNER OF BUILDING AND 0.20 M ABOVE GRADE.
 BMK319: ELVE. 310.607
 TABLET IN SOUTH FACE OF CONCRETE BASE FOR SIGNAL CONTROL BOX AT NORTH EAST CORNER OF MAPLE GROVE ROAD AND FOUNTAIN STREET. TABLET IS 0.10 M EAST OF SOUTH WEST CORNER OF BASE.
 BMK320: ELVE. 306.619
 TABLET IN WEST END OF RETAINING WALL IN ENTRANCE WAY TO WATERLOO REGIONAL POLICE HEADQUARTERS AND REGIONAL OPERATIONS CENTRE. RETAINING WALL IS LOCATED WHERE DRIVEWAY SPLITS TO RESPECTIVE BUILDINGS. TABLET IS LOCATED 0.3 M ABOVE GRADE.
 BMK322: ELVE. 309.787
 ELEVATION IS FOR A BRONZE TABLET SET IN A RED BRICK BUILDING (REGIONAL AMBULANCE BUILDING) @ THE SOUTHEAST CORNER OF CHERRY BLOSSOM DRIVE AND FOUNTAIN STREET.
 THE TABLET IS SET IN WEST WALL (ON BRICK) 0.15 M. NORTH OF THE SOUTH END OF BUILDING AND 0.15 M. ABOVE GRADE.

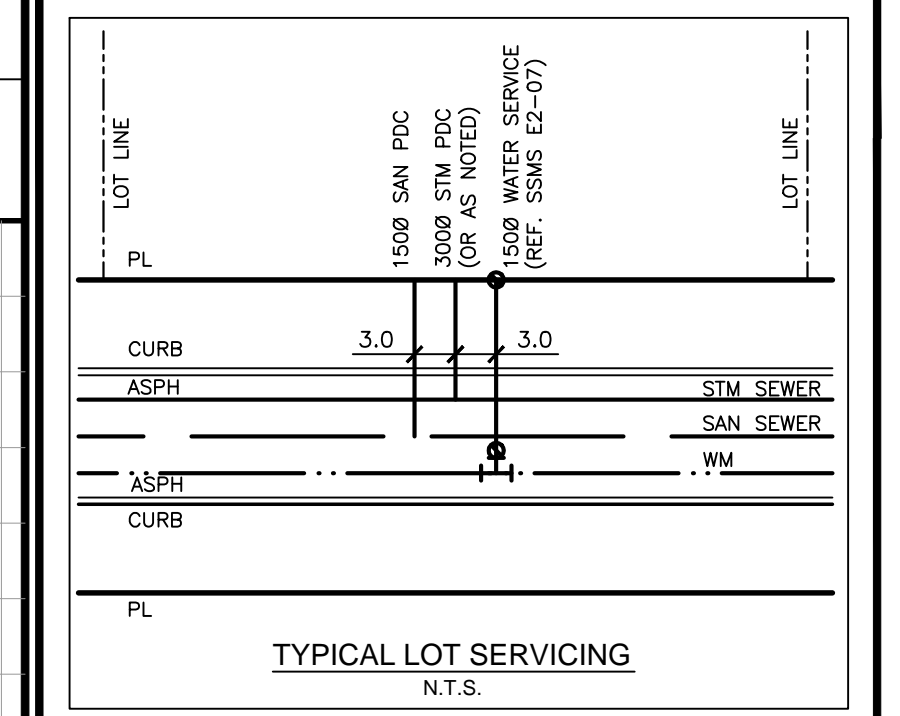

DRAWINGS TO BE READ IN CONJUNCTION WITH GEOTECHNICAL INVESTIGATION PREPARED BY CHUNG & VANDER DOELEN ENGINEERING LTD., FILE NO. 07-07-K20 SUB, DATED FEBRUARY 2, 2011.

THE PARCEL INFORMATION SHOWN ON THIS MAP IS COMPILED FROM VARIOUS SOURCES & IS NOT WARRANTED AS TO ITS ACCURACY BY THE MUNICIPALITY. USERS ARE REMINDED THAT LOT SIZES & LEGAL DESCRIPTIONS MUST BE CONFIRMED AT THE LAND REGISTRY OFFICE. THIS IS NOT A LEGAL DOCUMENT.
 THE LOCATIONS OF EXISTING UNDERGROUND UTILITIES ARE SHOWN IN AN APPROXIMATE WAY ONLY AND HAVE NOT BEEN INDEPENDENTLY VERIFIED BY THE OWNER OR THE CITY'S REPRESENTATIVE. THE CONTRACTOR SHALL DETERMINE THE EXACT LOCATION OF ALL EXISTING UTILITIES PRIOR TO CONSTRUCTION AND IS RESPONSIBLE FOR ANY OR ALL DAMAGES WHICH MIGHT OCCUR BY THE CONTRACTOR'S FAILURE TO EXACTLY LOCATE AND PRESERVE ANY AND ALL UNDERGROUND UTILITIES.

NO.	REVISION	BY	DATE
	AS CONSTRUCTED	R.P.	02/19/14

STAMP

SURVEY DATA:
 SURVEY BY: R.N.
 DATE: DECEMBER 2010
 FIELD BOOK:
 REQUISITION NO:
 CHECKED BY:
 DATE:


DRAWING INFORMATION:
 DRAWN BY: R.P./J.U.
 DATE: JANUARY 2012
 DESIGN BY: R.A.
 DATE: JANUARY 2012
 CHECKED BY: K.H.
 DATE: JANUARY 2012




Delcan 675 QUEEN STREET S. SUITE 201 KITCHENER, ONTARIO, CANADA N2M 2A1 TEL: (519) 744-4509 FAX: (519) 744-2822 WWW.DELCAN.COM

BOXWOOD SUBDIVISION
 HEROUX DEVTEK DR.
 STA. 0+300 TO STA. 0+600

SCALE: HORIZONTAL: 1:500 VERTICAL: 1:50
 DRAWING NO: **PP-03**

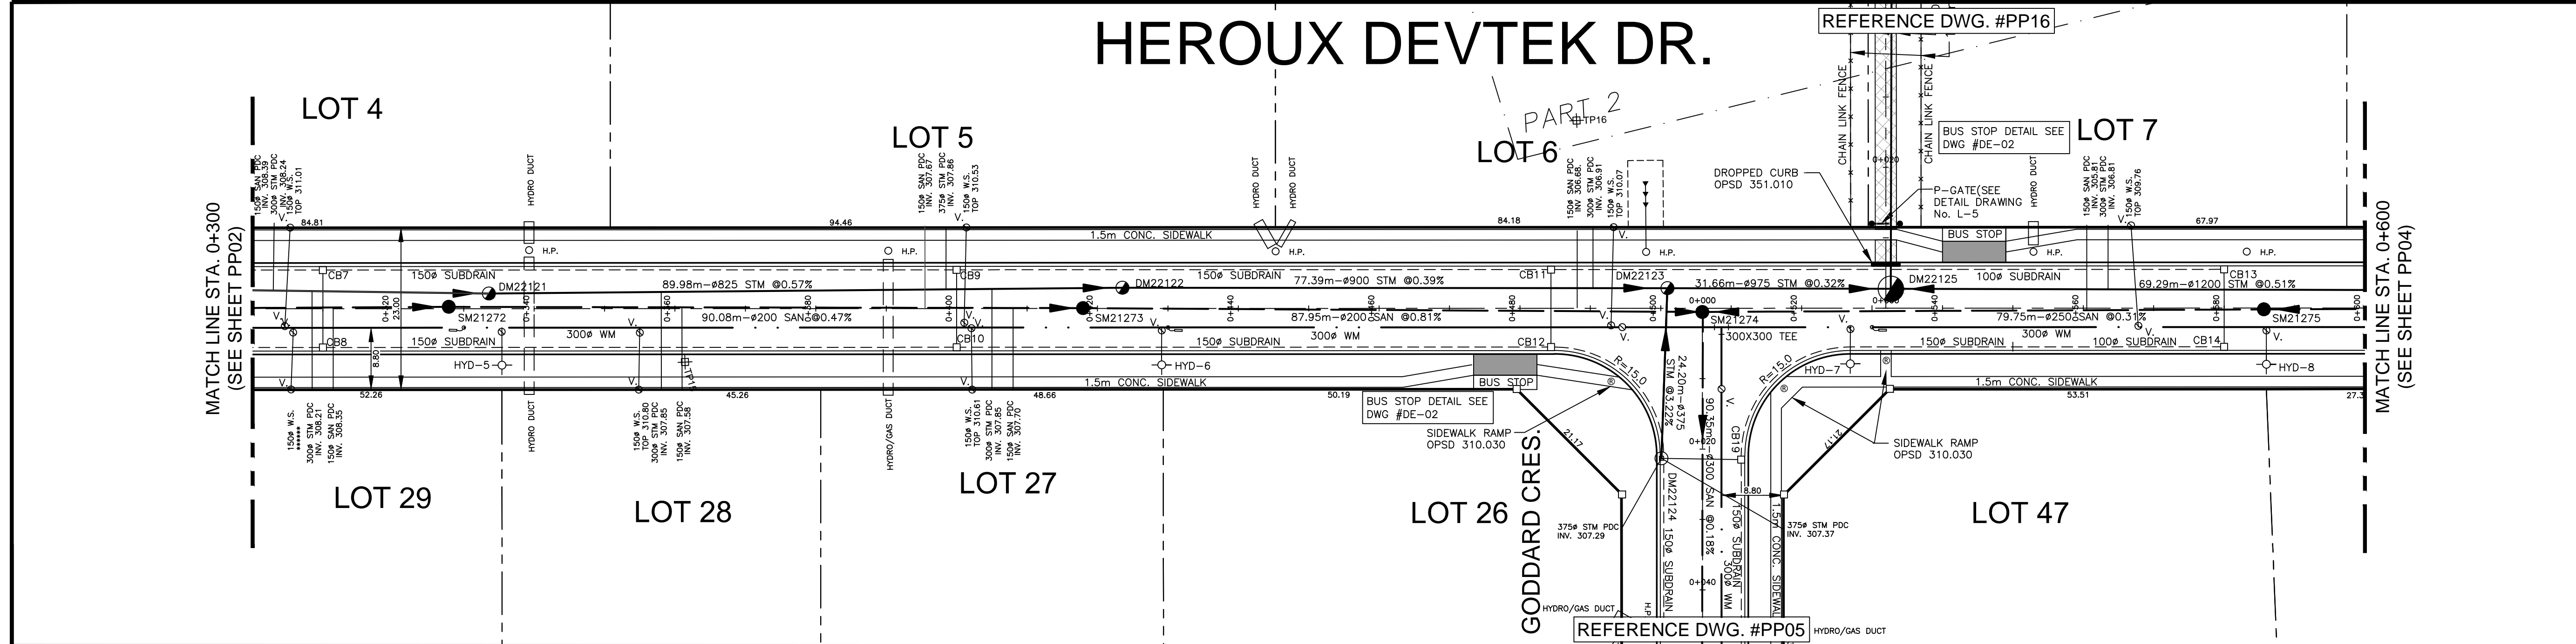

ROAD CENTERLINE ELEVATIONS	PRE DEVELOPMENT GROUND ELEVATIONS
310.980	311.17
310.880	310.80
310.780	310.53
310.680	310.32
310.580	310.20
310.480	310.07
310.380	309.95
310.280	309.88
310.180	310.02
310.080	309.88
309.980	309.61
309.950	309.59
309.880	309.57
309.780	309.49
309.680	309.68
309.580	309.79

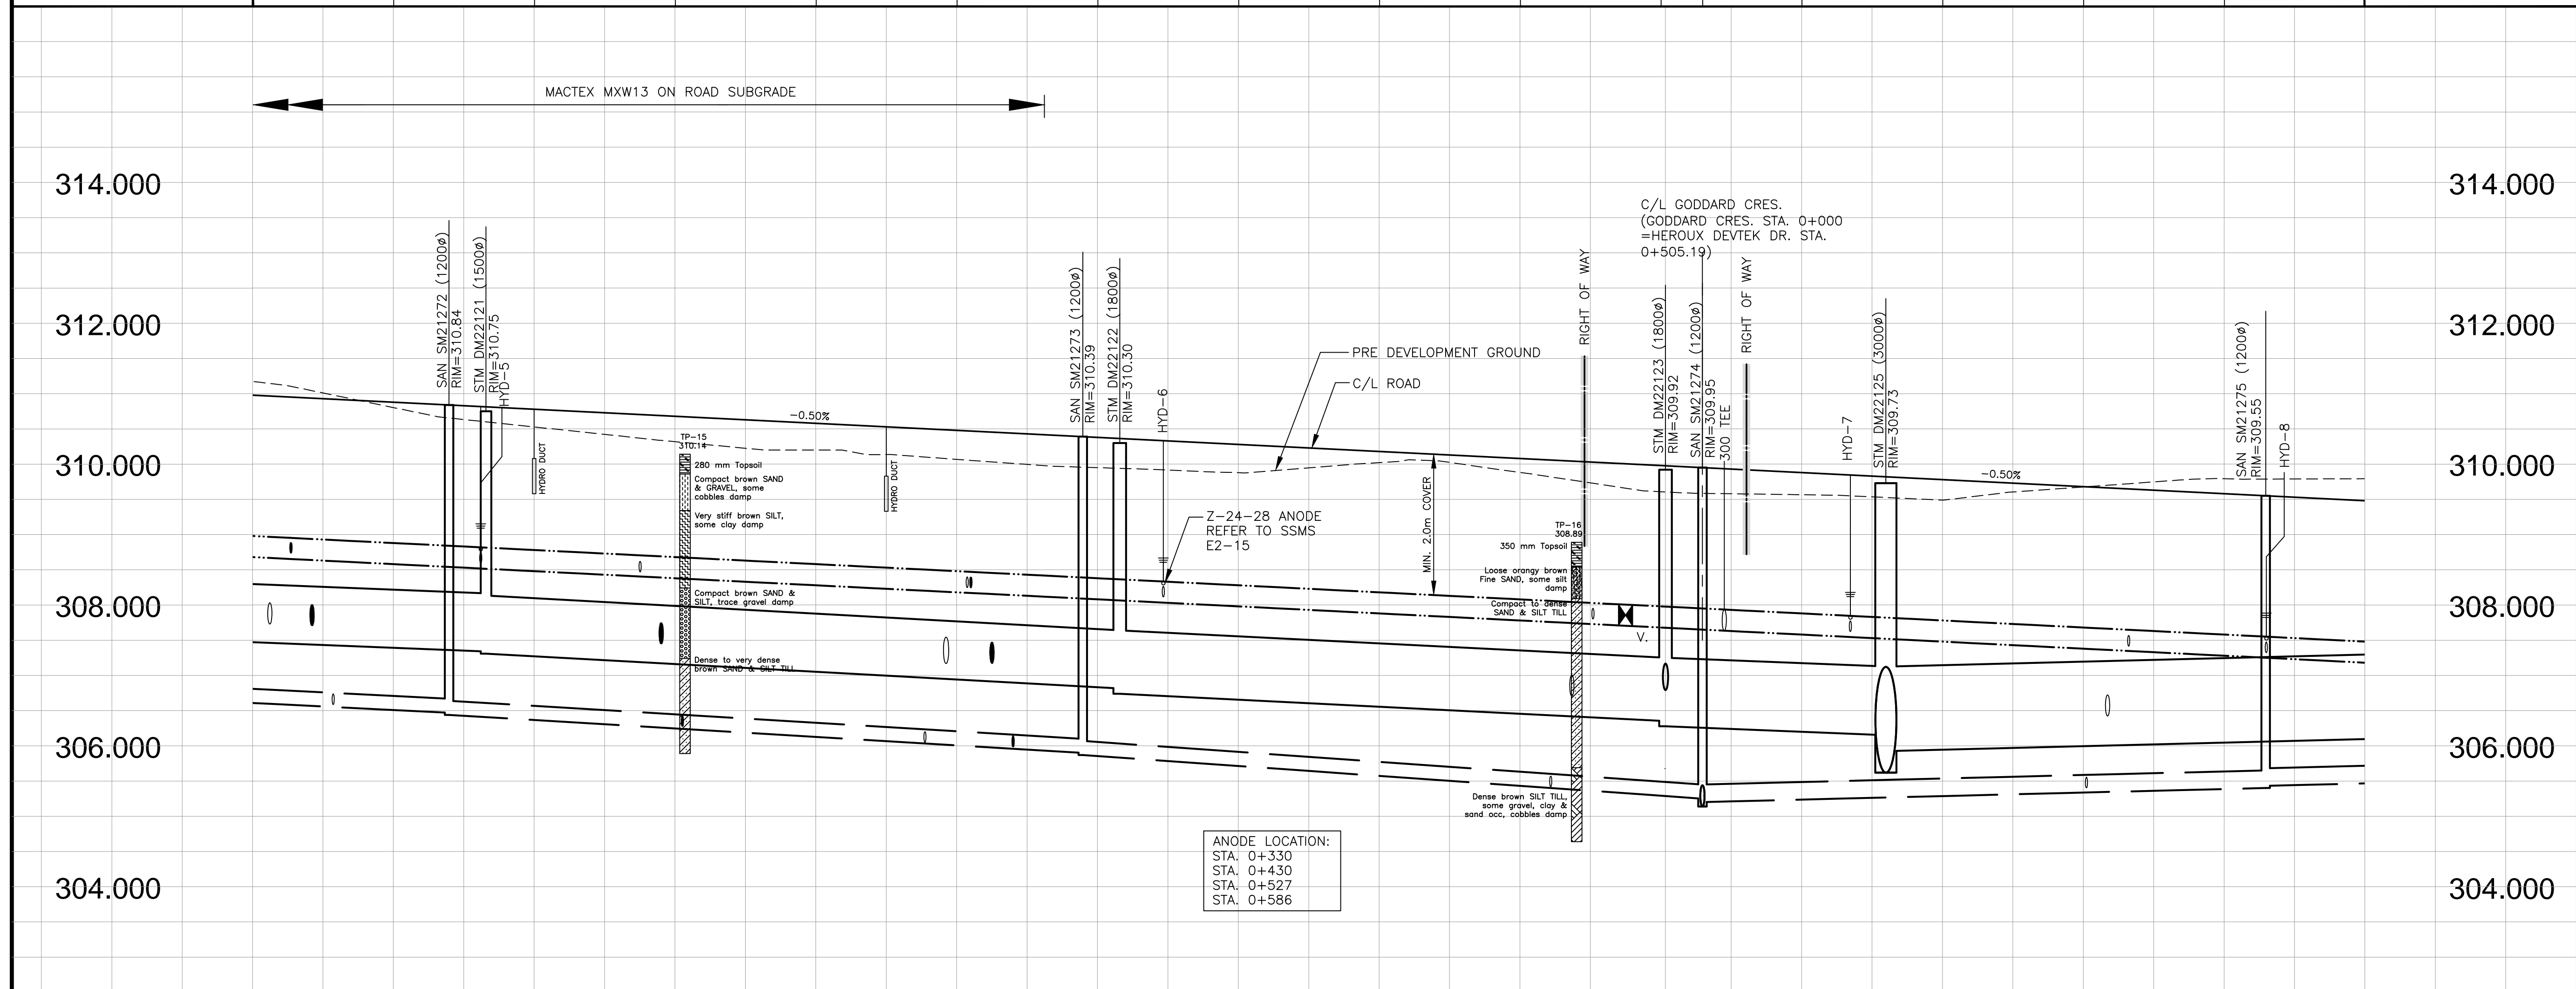

ANODE LOCATION:
 STA. 0+330
 STA. 0+430
 STA. 0+527
 STA. 0+586

TOP OF WATERMAIN	STORM INVERTS	SANITARY INVERTS	CHAINAGE	TOP OF WATERMAIN	STORM INVERTS	SANITARY INVERTS	CHAINAGE
319.55m OF 300mm DR-18 PVC WATERMAIN @ 0.50% GRADE	113.88m OF 825mm 65-D CONC. STM SEWER @ 0.39% GRADE	89.17m OF 200mm SDR-35 PVC SAN SEWER @ 0.61% GRADE	0+300	121.0m OF 300mm DR-18 PVC WATERMAIN @ 0.50% GRADE	69.29m OF 1200mm 65-D CONC. STM SEWER @ 0.51% GRADE	79.75m OF 250mm SDR-35 PVC SAN SEWER @ 0.31% GRADE	0+600
	89.98m OF 825mm 65-D CONC. STM SEWER @ 0.57% GRADE	90.08m OF 200mm SDR-35 PVC SAN SEWER @ 0.47% GRADE	0+320				
	77.39m OF 900mm 65-D CONC. STM SEWER @ 0.39% GRADE	87.95m OF 200mm SDR-35 PVC SAN SEWER @ 0.81% GRADE	0+340				
	31.66m OF 975mm 65-D CONC. STM SEWER @ 0.32% GRADE		0+360				
			0+380				
			0+400				
			0+420				
			0+440				
			0+460				
			0+480				
			0+500				
			0+520				
			0+540				
			0+560				
			0+580				