# BOXWOOD DRIVE

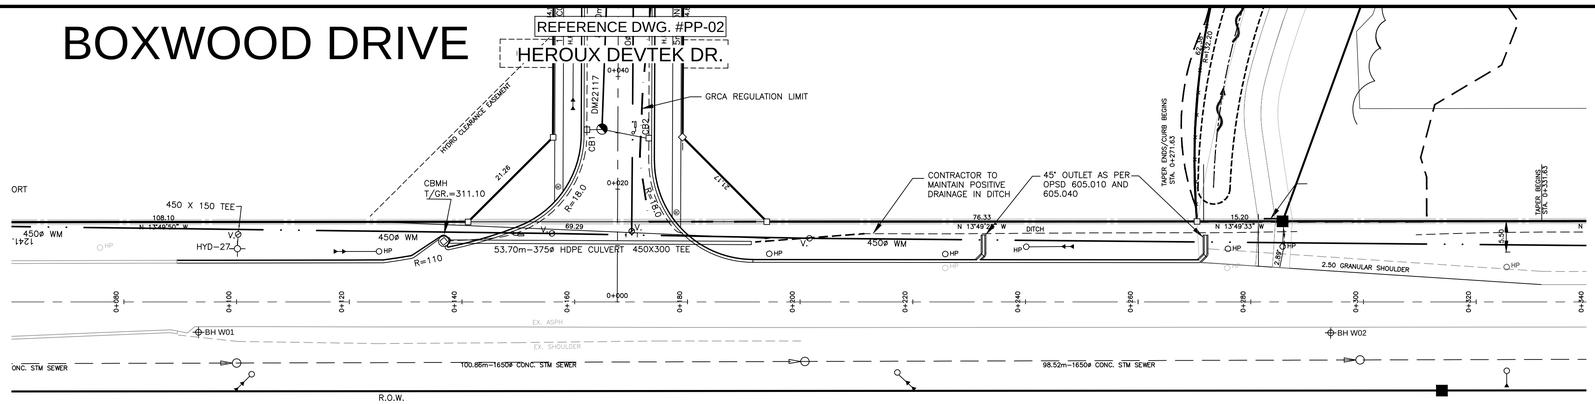


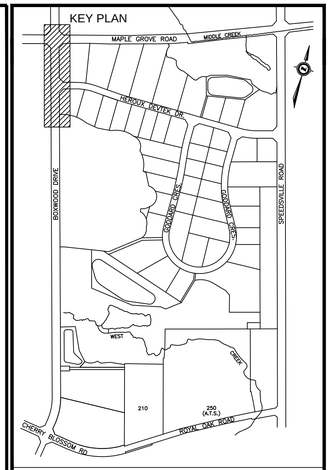


| CENTERLINE ELEVATIONS OF ROAD | | | | | | | 310.770 (HEROUX DEVTEK DR.) | | | | | | | | | CENTERLINE ELEVATIONS OF ROAD |
|---|---|---|---|---|---|---|---|---|---|---|---|---|---|---|---|---|
| PRE DEVELOPMENT CENTERLINE ELEVATIONS OF ROAD | 313.33 | 312.80 | 312.52 | 312.08 | 311.54 | 310.93 | 310.77 | 310.44 | 309.91 | 309.49 | 309.14 | 308.86 | 308.65 | 308.51 | 308.39 | 308.28 | 308.16 | PRE DEVELOPMENT CENTERLINE ELEVATIONS OF ROAD |

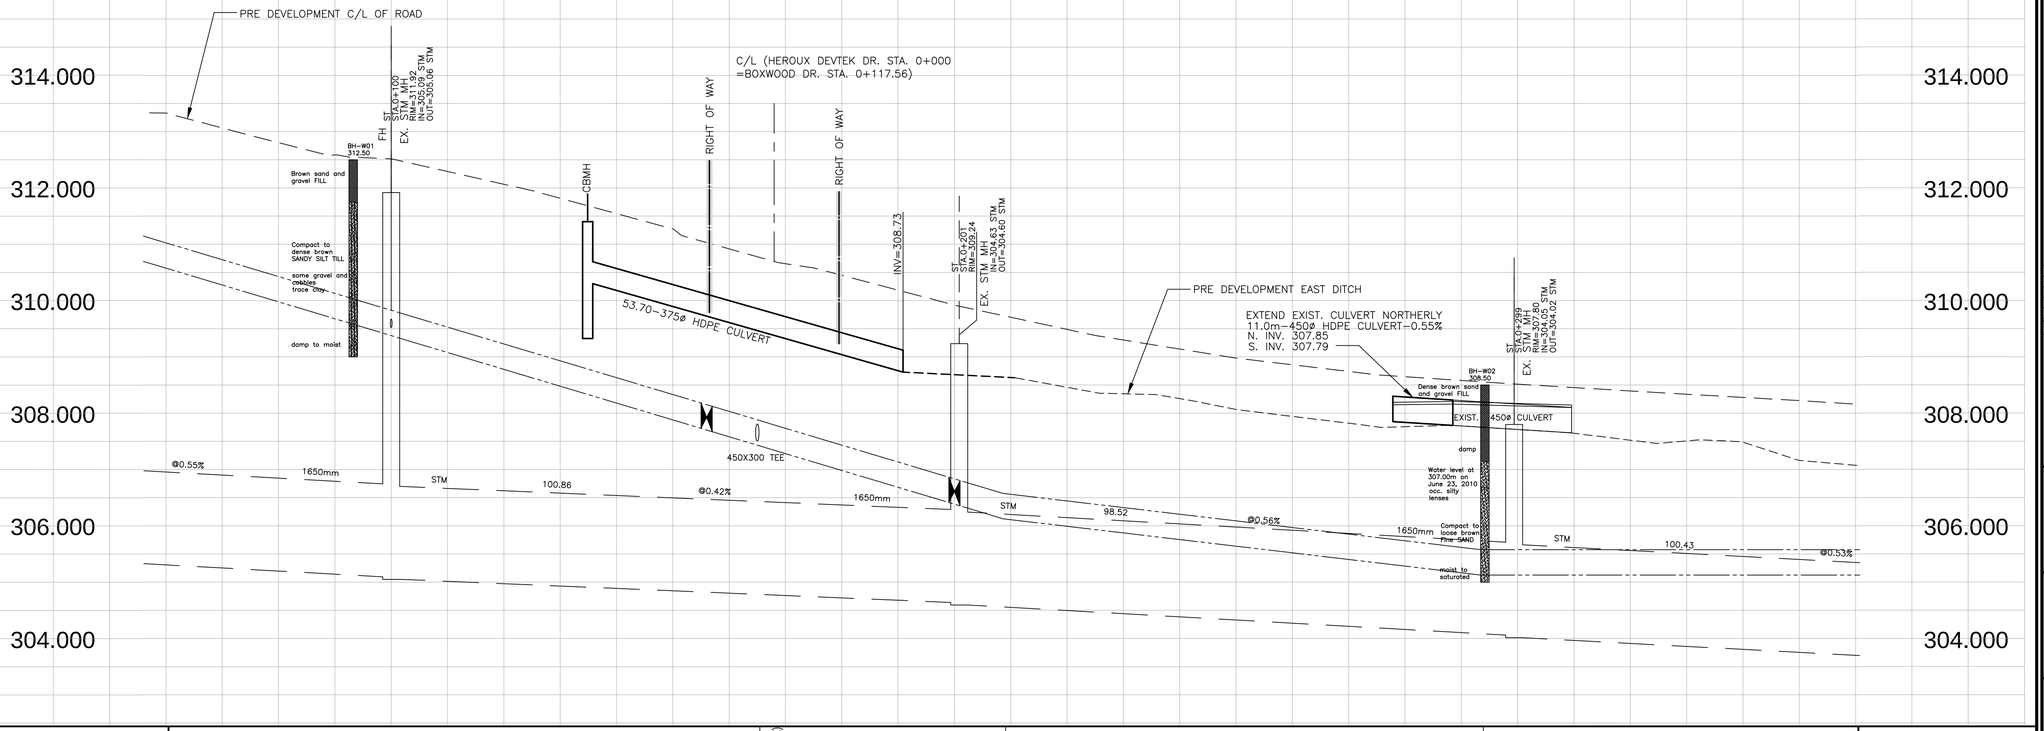


| TOP OF WATERMAIN | 177.0m OF 450mmø DR-25 PVC WATERMAIN @ 3.00% GRADE | 307.61 (450x300 TEE) | 306.58 | 200.00m OF 450mmø DR-25 PVC WATERMAIN @ 2.38% GRADE | 306.83 | 165.0m OF 450mmø DR-25 PVC WATERMAIN @ 0.00% GRADE | TOP OF WATERMAIN |
|---|---|---|---|---|---|---|---|
| STORM INVERTS | EX. 107.2m OF 1650mmø 65-D CONC. STM SEWER @ 0.55% GRADE 305.09N1650 305.06S1650 | 310.30S0375 | EX. 100.86m OF 1650mmø 65-D CONC. STM SEWER @ 0.42% GRADE | 304.83N1650 304.66S1650 | EX. 98.52m OF 1650mmø 65-D CONC. STM SEWER @ 0.56% GRADE | 304.05N1650 304.02S1650 | EX. 100.43m OF 1650mmø 65-D CONC. STM SEWER @ 0.53% GRADE | STORM INVERTS |
| SANITARY INVERTS | | | | | | | | SANITARY INVERTS |
| CHAINAGE | 0+060 | 0+080 | 0+100 | 0+120 | 0+140 | 0+160 | 0+180 | 0+200 | 0+220 | 0+240 | 0+260 | 0+280 | 0+300 | 0+320 | 0+340 | CHAINAGE |

J:\DATA\EM3528\6B_Dwg\Contract Drawings\BOXWOOD NORTH CONTRACT\AS CONSTRUCTED\M-5PP012 (500 scl).dwg; PLOT TIME: Apr 29, 2015 - 1:25pm

**BENCH MARKS**

RMW317: ELVE. 306.269
TABLET IN FOUNDATION OF WHITE BRICK PORTION OF FORMER MAPLE GROVE SCHOOL ON MAPLE GROVE ROAD AT SPEEDSVILLE ROAD. TABLET IS IN SOUTH SIDE OF BUILDING 0.10M WEST OF SOUTH EAST CORNER OF BUILDING AND 0.20 M ABOVE GRADE.

RMW319: ELVE. 310.607
TABLET IN SOUTH FACE OF CONCRETE BASE FOR SIGNAL CONTROL BOX AT NORTH EAST CORNER OF MAPLE GROVE ROAD AND FOUNTAIN STREET. TABLET IS 0.10 M EAST OF SOUTH WEST CORNER OF BASE.

RMW320: ELVE. 306.619
TABLET IN WEST END OF RETAINING WALL IN ENTRANCE WAY TO WATERLOO REGIONAL POLICE HEADQUARTERS AND REGIONAL OPERATIONS CENTRE. RETAINING WALL IS LOCATED WHERE DRIVEWAY SPLITS TO RESPECTIVE BUILDINGS. TABLET IS LOCATED 0.3 M ABOVE GRADE.

RMW332: ELVE. 309.787
ELEVATION IS FOR A BRONZE TABLET SET IN A RED BRICK BUILDING [REGIONAL AMBULANCE BUILDING] @ THE SOUTHEAST CORNER OF CHERRY BLOSSOM DRIVE AND FOUNTAIN STREET.
THE TABLET IS SET IN WEST WALL (IN BRICK) 0.15 M. NORTH OF THE SOUTH END OF BUILDING AND 0.15 M. ABOVE GRADE.

NOTE #1
HYDRO POLES AND ALL HYDRO WORKS PERFORMED BY CAMBRIDGE AND NORTH DUMFRIES HYDRO INC.

DRAWINGS TO BE READ IN CONJUNCTION WITH GEOTECHNICAL INVESTIGATION PREPARED BY CHUNG & VANDER DOELEN ENGINEERING LTD., FILE NO. 07-07-K20 SUB, DATED FEBRUARY 2, 2011.

THE PARCEL INFORMATION SHOWN ON THIS MAP IS COMPILED FROM VARIOUS SOURCES & IS NOT WARRANTED AS TO ITS ACCURACY BY THE MUNICIPALITY. USERS ARE REMINDED THAT LOT SIZES & LEGAL DESCRIPTIONS MUST BE CONFIRMED AT THE LAND REGISTRY OFFICE. THIS IS NOT A LEGAL DOCUMENT.

THE LOCATIONS OF EXISTING UNDERGROUND UTILITIES ARE SHOWN IN AN APPROXIMATE WAY ONLY AND HAVE NOT BEEN INDEPENDENTLY VERIFIED BY THE OWNER OR THE CITY'S REPRESENTATIVE. THE CONTRACTOR SHALL DETERMINE THE EXACT LOCATION OF ALL EXISTING UTILITIES PRIOR TO CONSTRUCTION AND IS RESPONSIBLE FOR ANY OR ALL DAMAGES WHICH MIGHT OCCUR BY THE CONTRACTOR'S FAILURE TO EXACTLY LOCATE AND PRESERVE ANY AND ALL UNDERGROUND UTILITIES.

| NO. | REVISION | BY | DATE |
|---|---|---|---|
| | AS CONSTRUCTED | R.P. | 02/19/14 |

TRUE

STAMP

| SURVEY DATA: | | DRAWING INFORMATION: | |
|---|---|---|---|
| SURVEY BY: | R.N. | DRAWN BY: | R.P./J.U. |
| DATE: | DECEMBER 2010 | DATE: | JANUARY 2012 |
| FIELD BOOK: | | DESIGN BY: | R.A. |
| REQUISITION NO: | – | DATE: | JANUARY 2012 |
| CHECKED BY: | – | CHECKED BY: | K.H. |
| DATE: | – | DATE: | JANUARY 2012 |

CAMBRIDGE CANADA


Delcan
675 QUEEN STREET S.
SUITE 201,
KITCHENER, ONTARIO, CANADA
N2M 1A1
TEL: (519) 744-4509
FAX: (519) 744-2822
WWW.DELCAN.COM


# BOXWOOD SUBDIVISION

BOXWOOD DRIVE

STA.0+060 TO STA.0+360

| SCALE: | | DRAWING NO: |
|---|---|---|
| HORIZONTAL: | 1:500 | PP-01 |
| VERTICAL: | 1:50 | |